


PF-1 - TEMPORARY CHANNEL


PLAN MAP PF-1
SCALE: 1" = 120'

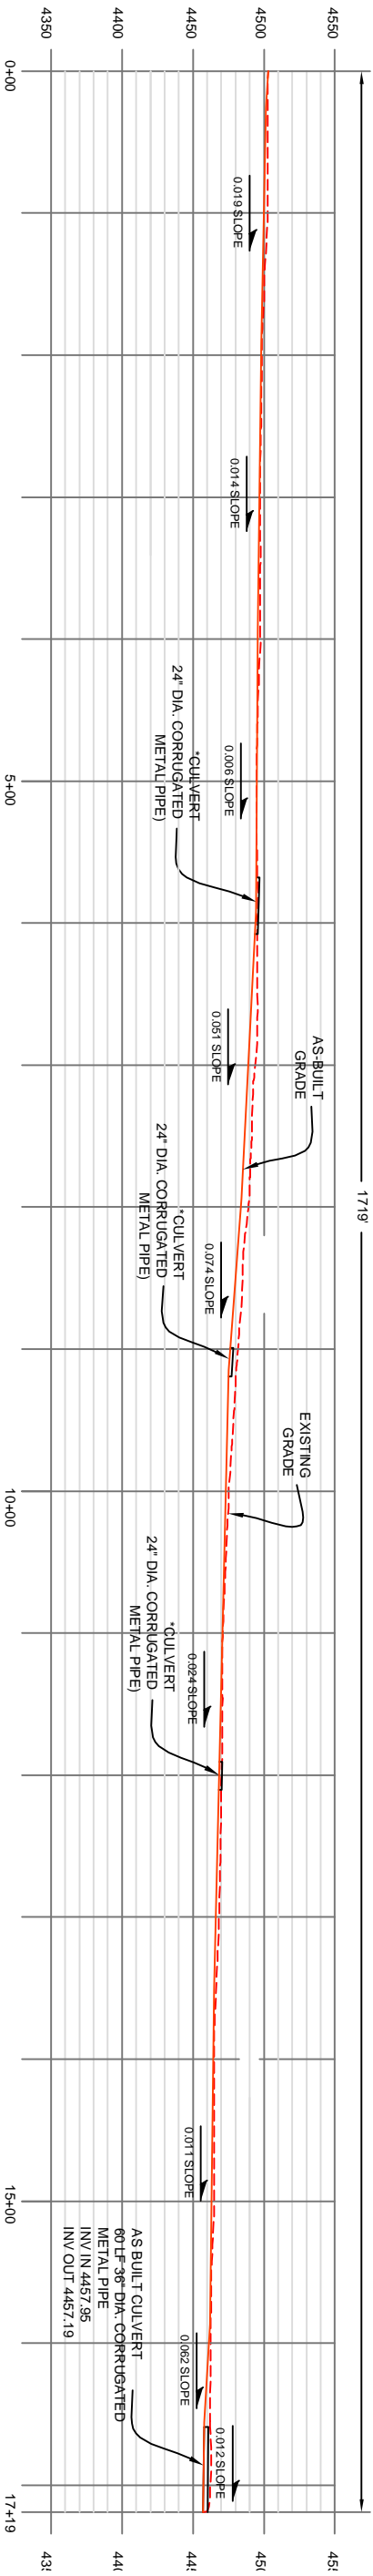

AS-BUILT

These as-built plans are based on the information compiled and furnished by others. The compiled information represented on these drawings is not intended to represent in detail the exact location, type of component nor manner of construction.

PROFILE PF-1
SCALE: 1" = 60'

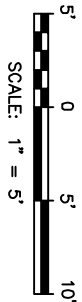

AS BUILT CULVERT
SCALE: 1" = 5'

AS BUILT CULVERT
SCALE: 1" = 5'

LEGEND	
	MINE PERMIT BOUNDARY
	UNDERGROUND MINE WORKING
	EXISTING TOPOGRAPHIC CONTOUR
	PROPOSED TOPOGRAPHIC CONTOUR
	EXISTING CULVERT
	PROPOSED CULVERT
	EXISTING ROADS
	PROPOSED ROADS
	SITE ROADS
	FENCE
	EXISTING DRAINAGES
	PROPOSED PERMANENT DIVERSION CHANNEL
	PROPOSED TEMPORARY CHANNEL
	EXISTING ADIT
	EXISTING SURFACE (PROFILE)
	AS-BUILT SURFACE (PROFILE)
	AS-BUILT SURVEY POINTS
	Pt. #
	X Elev.
	Decp.

NOTE: SURVEY DATA ALONG THE TEMPORARY CHANNEL PROVIDED BY OTHERS.

AS BUILT DRAWING

APPROVED	DATE	PREP. BY	DESCRIPTION	SYMBOL
			REVISIONS	

DESIGNED BY: CAW	RE-CHECKED BY: TLS
DRAWN BY: DMF	APPROVED BY: RG
CHECKED BY: MRR	DATE: 05/21/2008

SIZE D
IF SHEET IS LESS
THAN 22" X 34"
IT IS A REDUCED
PRINT
SCALE REDUCED
ACCORDINGLY

Prepared for:
DENISON MINES
TONY M MINE
PHASE 1 PROFILE OF PF-1 CHANNEL
AS-BUILT

Tony M Mine
Garfield County, Utah

EXHIBIT
G-3